## SRAA+E

Architecture + Engineering, P.C

Case Cloister East, Inc. v. NY SLA

Exhibit

Aug 13, 2020

To whom it may concern,

I am the Managing Principal at SRA Architecture and Engineering a firm specializing in architecture, engineering, expediting, and code compliance. We are specialists in obtaining New York City Department of Buildings (NYCDOB) approvals to construct Eating and Drinking Establishments. I have been a New York State licensed architect for over 26 years. I have signed, stamped, expedited, and obtained NYCDOB approvals for over 200 Eating and Drinking Establishments applications. Throughout my career, I have solved difficult layouts to maintain safe Eating and Drinking Establishments. I have filed and obtained NYCDOB Place of Assembly Certificate of Operation for each establishment over 74 occupants.

Based on DOB Approved Application #121692329, I can attest to the fact that the Cloister Cafe at 238 East 9<sup>th</sup> Street (Tax Lot #32) is an Eating and Drinking Establishment with an outdoor space in the Rear Yard and has a connecting Courtyard (Tax Lot #31) open to the sky. Cloister Café has a DOB Approved Place of Assembly Certificate of Operation #122720314 for 136 occupants issued on 10/11/2017 and a FDNY Place of Assembly Account #27245562, expiring on 11/30/2020

DOB Approved Application #121692329, attached, drawing indicates an Existing Rear Yard with Seasonal Temporary Enclosure constructed of metal framing, canvas roof with plastic wall panels.

According to DOB Approved Application #121692329 the Rear Yard, is considered outdoor, with an DOB approved weather canvas covering and a total legal capacity of 71. Cloister Café, being cautious and consciousness, has chosen to have 30 feet of the south wall open to the air and allow natural circulation. The open-air Courtyard has a legal occupancy of 60.

According to DOB Approved Application #121692329, Exit A, 36" door (from the Eating and Drinking Establishment), can support a Maximum Egress capacity of 75 occupants; and Exit B, 10'-4" opening with roll down gate (from Courtyard) can support a Maximum Egress capacity of 275 occupants for a total Maximum Egress capacity of 350 occupants.

According to DOB Approved Applications both outdoor/open air spaces have been legally permitted as Eating and Drinking Establishment for many years.

I have personally been to Cloister Cafe on a number of occasions, during the pandemic, and can say with 100% certainty, that this is an Outdoor Space which is consistent with DOT Open Sidewalk and Roadway Seating Programs, and also both spaces are approved by NYCDOB and FDNY and therefore legally permitted.



- 1. EXIT SIGNS SHALL CONFORM TO ALL PROVISIONS OF SUB-CHARPTER 6, ARTICLE 7 AND SECT 27-525 OF THE A.C. AND AS FOLLOWS:
- A) SIGNS SHALL BE INTERNALLY LIGHTED AND CONNECTED TO A POWER SOURCE AHEAD OF THE MAIN CIRCUIT BREAKERS.
- B) LIGHTS SHALL BE KEPT LIT ALL TIMES DURING OCCUPANCY OF PREMISES.

Page 2 of 7

- C)INSTALLATION OF SIGNS SHALL BE SUCH THAT THEY ARE CLEARLY VISIBLE FROM ALL PLACES IN ASSEMBLY SPACE WITH THE BOTTOM OF SIGNS AT A HEIGHT OF AT LEAST 7'-0" ABOVE FLOOR LEVEL.
- D)LETTERS OF SIGNS SHALL BE RED BLOCK LETTERS AT LEAST 8" HIGH WITH MINIMUM 3/4" WIDE STROKES.

  BACKGROUND TO BE STENCILED METAL, LIGHT GRAY OR WHITE IN COLOR OR OF TRANSLUCENT FROSTED GLASS OR SLOW BURNING PLASTIC.
- 2. EMERGENCY LIGHTING SYSTEM SPECIFIED UNDER THIS FILING SHALL CONFORM TO ALL PROVISIONS OF SECTION C27-525 OF THE A.C. AND SPECIFIED BY LOCAL LAW 41/78. A) ASSEMBLY SPACES SHALL BE PROVIDED WITH EMERGENCY LIGHTS SUFFICIENT TO ILLUMINATE FLOOR
- EMERGENCY LIGHTS SUFFICIENT TO ILLUMINATE FLOOR LEVEL WITH A MIN OF 5 FT. CANDLES AT ALL AISLES AND EXIT AREAS.
- B) EXIT AREAS TO BE ILLUMINATED WITHIN THE ASSEMBLY SPACE SHALL CONSIST OF THE EXIT SIGN, EXIT DOORWAY AND A SQUARE AT THE THRESHOLD OF THE POINT OF EGRESS WITH A SIDE WHOSE DIMENSION IS DOUBLE THE DOOR'S OPENING, OR EQUAL TO THE WIDTH OF AN ENCLOSED CORRIDOR (WHICHEVER IS LESS) LIGHT MEASUREMENT SHALL BE TAKEN ON THE HORIZONTAL.
- C) THE INTENSITY OF GENERAL ILLUMINATION SHALL NOT BE DIMENSIONED TO LESS THAN 2 FT. CANDLES AT A LEVEL OF 18" ABOVE FLOOR LEVEL AT CROSS AISLES.
- D) THE INTENSITY OF GENERAL ILLUMINATION ELSEWHERE IN THE ASSEMBLY SPACE SHALL NOT BE DIMENSIONED TO LESS THAN 1 FT. CANDLE AT A LEVEL OF 18" ABOVE FLOOR LEVEL.
- E) LIGHTING UNITS SHALL BE ARRANGED SO AS NOT TO INTRODUCE DISORIENTING GLARE TO THE PATH OF ESCAPE, DRAMATICALLY ALTER THE CHARACTER AND QUALITY OF ILLUMINATION OR OTHERWISE PRESENT HAZARD TO THE OCCUPANTS.
- F) ILLUMINATION SHALL BE ARRANGED SO THAT THE EVENT OF THE FAILURE OF ANY SINGLE LIGHTING UNIT, SUCH AS THE BURNING OUT OF AN ELECTRIC BULB, NO AREA WILL BE LEFT IN ENTIRE DARKNESS.
- G) EMERGENCY LIGHTS SHALL BE CONNECTED TO AN INTERNAL POWER SOURCE SEPARATE FROM GENERAL LIGHTING SYSTEMS, THIS BATTERY OPERATED INTERNAL POWER SYSTEM MAY HOWEVER BE RECHARGED FROM GENERAL LIGHTING AND POWER CIRCUITS IF SO DESIRED H) ALL FIXTURES SHALL BE INSTALLED AT A MINIMUM OF
- H) ALL FIXTURES SHALL BE INSTALLED AT A MINIMUM OF 8'-0" ABOVE FLOOR LEVEL.
- 3. MINIMUM WIDTH OF AISLES CROSS AISLES SHALL BE 44" AND EACH AISLE SHALL LEAD TO APPROVED MEANS OF EGRESS EXCEPT:
- A)IN ANY ASSEMBLY SPACE HAVING A TOTAL OF NOT MORE THAN THREE HUNDRED OCCUPANTS,
  B)WHEN NOT MORE THAN THE NUMBER OF PERSONS

PERMITTED FOR ONE UNIT OF EXIT WIDTH IS SERVED.

- C)AT THE NARROWEST POINT WHEN A TAPERED AISLE IS PERMITTED UNDER PARAGRAPH THREE OF B.C. 27-532.


  D)WHEN AN AISLE PARALLELS AND IS ALONGSIDE AN ENCLOSURE WALL OR PARTITION THAT IS PROVIDED WITH EXIT DOORS SPACED NOT MORE THAN SIXTEEN FEET ON CENTERS, PROVIDED SUCH AISLE SERVES ONLY THE ROWS OF SEAT ADJACENT TO IT.
- 4. A POSTED OCCUPANCY SIGN SHALL BE PROVIDED AS PRESCRIBED BY SECT. 27-527 MIN. SIZE TO BE 12" WIDE X 16" HIGH, LETTER SHALL BE RED, 1" HIGH, NUMERALS RED BUT 1-1/4" HIGH, SIGN SHALL BE PERMANENTLY MOUNTED WITH A MINIMUM OF 5 FT. CANDLES OF LIGHT.
- 5. EXIT DOORS AND HARDWARE SHALL COMPLY WITH ALL REQUIREMENTS OF SECT. 27-371 OF A.C. AND AS FOLLOWS:


  A)) EXIT DOORS MAY NOT BE LOCKED AT ANY TIME DURING OCCUPANCY OF PREMISED AND SHALL BE KEPT CLEAR OF OBSTRUCTIONS AND READILY OPERABLE AT ALL TIMES FROM THAT SIDE OF THE EGRESS.
- B)DOORS SHALL NOT REQUIRE A KEY LOCK FROM SIDE OF EGRESS, SLIDE LOCKS, DEAD BOLTS, KEY LOCKS AND HARDWARE OTHER THAN N.Y.C. BUILDING DEPARTMENT AND B.S.A.
- 6. HOODS, FLUES, DUCTS AND GREASE FILTERS OVER COOKING RANGES AND OTHER APPLIANCES MUST BE MAINTAINED REGULARLY TO INSURE CLEANLINESS AND SAFETY. AN UP TO DATE MAINTENANCE RECORD OF THESE SERVICES FOR THE PAST 3 MONTHS SHALL BE KEPT ON PREMISES AND SHOWN TO THE BUILDING DEPARTMENT AND THE FIRE INSPECTOR AS REQUIRED.
- 7. AN APPROVED COPY OF THIS PLAN SHALL BE FRAMED AND KEPT ON PREMISES BY OWNER FOR INSPECTION BY N.Y.C. OFFICIALS AS REQUIRED BY N.Y.C.A.C. & LL 41778.
- 8. NO PLACE OF ASSEMBLY SHALL BE LOCATED WITHIN 250'
  -0" OF ANY OCCUPANCY CONTAINING EXPLOSIVE MATERIALS.

- 1. SEATING AS SHOWN ON PLAN SHALL COMPLY WITH SECTION C26-891.4
- 2. WHERE EXIT SIGNS ARE INDICATED ON THE PLAN THEY SHALL BE AT LEAST 8" IN HEIGHT WITH STROKES AT LEAST 3/4" WIDE COMPLYING WITH ALL THE REQUIREMENTS OF SUB-ARTICLE 606.0, C26-801, IOE0 AND C26-801.17.
- 3. SIGNS SHALL BE INTERNALLY LIGHTED TYPE IN ALL ASSEMBLY SPACES WHERE THE GENERAL ILLUMINATION IS REDUCED TO LESS THAN FIVE (5) FOOT CANDLES DURING OCCUPANCY. SIGNS SHALL BE LIGHTED AT ALL TIMES DURING OCCUPANCY WITH COMPLIANCE TO C26-80.1.17.
- 4. THE ENTIRE EXHAUST SYSTEM FOR COOKING EQUIPMENT, INCLUDING DUCTS, HOODS AND SHALL BE INSPECTED PERIODICALLY AND THOROUGHLY CLEANED GREASE FILTERS SHALL SERVICED AND REPLACED REGULARLY BY QUALIFIED EMPLOYEES OF THE OWNER OR BY A CLEANING AGENCY, A RECORD INDICATING THE NAME OF THE PERSON OR THE FIRM DOING THE SERVICING AND THE DATES WHEN THE FILTERS WERE CLEANED OR REPLACED SHALL BE KEPT ON THE PREMISES AND SHALL BE AVAILABLE FOR INSPECTION BY THE COMMISSIONER AS FREQUENTLY AS NECESSARY BUT AT LEAST EVERY THREE MONTHS: AT LEAST TWICE A YEAR THE AUTOMATIC FIRE DAMPER LOCATED AT THE HOOD OUTLET RELEASE DEVICES AND FUSIBLE LINKS, IF EMPLOYED SHALL BE PROPERLY CLEANED AND OR REPLACED. AT LEAST ONCE EVERY YEAR THE AUTOMATIC VALVE OPERATION AND EXTINGUISHING SYSTEM SHALL BE TESTED, A RECORD OF SUCH TEST SHALL BE KEPT ON THE PREMISES AND SHALL BE AVAILABLE FOR INSPECTION BY THE COMMISSIONER OF BUILDINGS AND THE FIRE COMMISSIONER, C-26-1370 AND RS 13-3. A PERMIT SHALL BE SECURED FROM THE DEPARTMENT OF BUILDINGS: ANNUAL FEE SHALL BE PAID TO THE DEPARTMENT UPON ISSUANCE OF A PERMIT C26-34.0. DRAPES, CURTAINS, DECORATION AND SCENERY HAVING FLAME SPREAD RATINGS EXCEEDING 25 SHALL BE FLAMEPROOFED IN COMPLIANCE WITH C19-161.1 OF THE FIRE CODE C26-802.2.
- 5. ALL POINTS ARE WITHIN 125'-0" OF THE MAIN EXIT AS PER C26-1438 OBC. OWNER WILL PROVIDE A CAPACITY SIGN OF 20"X24' FOR THE APPROVED NUMBER OF PERSONS WHERE INDICATED AS PER C26-1440 OBC.

## NOTES RELATED TO EMERGENCY LIGHTING

- 1. INSTALL APPROVED TYPE BATTERY EMERGENCY LIGHTS AS SHOWN ON PLANS, SAME TO BE APPROVED BY THE DEPARTMENT OF BUILDINGS AND BUREAU OF FIRE PREVENTION, & FIRE DEPARTMENT. INSTALLATION TO BE DONE BY A LICENSED ELECTRICIAN WHO SHALL OBTAIN ELECTRIC DEPARTMENT CERTIFICATE AND COMPLY WITH N.Y.C. ELECTRICAL CODE.
- 2. ALL BATTERY PACKS LIGHT ALARM 12 VOLTS WITH 25 WATT LAMPS.
- 3. ALL BATTERY PACKS TO BE MOUNTED 8'-0" ABOVE FINISHED FLOOR MIN.
- 4. ALL OTHER PACKS TO HAVE A MIN. OF TWO LAMPS EACH.
- 5. ALL DIMENSIONS SHOWN ARE PLUS OR MINUS.
- 6. NEW EMERGENCY LIGHTING TO CONFORM TO DIRECTIVE 5/79. MEMO 2-19-81 AND COMPLY WITH C27-542 PARAGRAPHS (1) (6) OF THE N.Y.C. BUILDING CODE.
- 7. A MIN. OF FIVE FOOT CANDLES OF ILLUMINATION AT THE FLOOR LEVEL MUST BE PROVIDED AT ALL EXIT AREAS.
- 8. THE EXIT AREA TO BE ILLUMINATED WITHIN THE ASSEMBLY SPACE SHALL CONSIST OF THE EXIT SIGN, THE EXIT DOORWAY AND A SQUARE AT THE THRESHOLD OF THE POINT OF EGRESS WITH A SIDE WHOSE DIMENSION IS DOUBLE THE WIDTH OF THE EGRESS OPENING OR EQUAL TO THE WIDTH OF THE CORRIDOR, WHICHEVER IS LESS.
- 9. THE INTENSITY OF ILLUMINATION SHALL NOT BE DIMINISHED TO LESS THAT TWO FOOT CANDLES AT A LEVEL 18" ABOVE THE FLOOR AT CROSS AISLES.
- 10. THE INTENSITY OF GENERAL ILLUMINATION SHALL NOT BE DIMINISHED TO LESS THAT ONE FOOT CANDLE AT A LEVEL 18" ABOVE THE FLOOR ELSEWHERE.
- 11. THE LIGHTING UNITS SHALL BE SO ARRANGED SO AS NOT TO:
  A)INTRODUCE DISORIENTING GLARE TO THE PATH OF ESCAPE.
  B) DRAMATICALLY ALTER THE CHARACTER AND QUALITY OF ILLUMINATION.
- C)PRESENT A HAZARD TO THE OCCUPANTS AND BE PROTECTED AS NECESSARY.
- 12. ILLUMINATION SHALL BE SO ARRANGED THAT THE FAILURE OF ANY SINGLE LIGHTING UNIT SUCH AS THE BURNING OUT OF AN ELECTRIC BULB WILL NOT LEAVE ANY AREA IN DARKNESS.
- 13. EXIT LIGHT SHALL BE ON CIRCUITS THAT ARE SEPARATE FROM GENERAL LIGHTING AND POWER CIRCUITS, EITHER TAKEN OFF AHEAD OF THE MAIN SWITCH OR CONNECTED TO ANY EMERGENCY LIGHTING POWER SOURCE WHEN SUCH IS PROVIDED. HOWEVER, AN EMERGENCY LIGHTING POWER SOURCE IF BATTERY OPERATED MAYBE RECHARGED FROM THE GENERAL LIGHTING AND POWER CIRCUITS

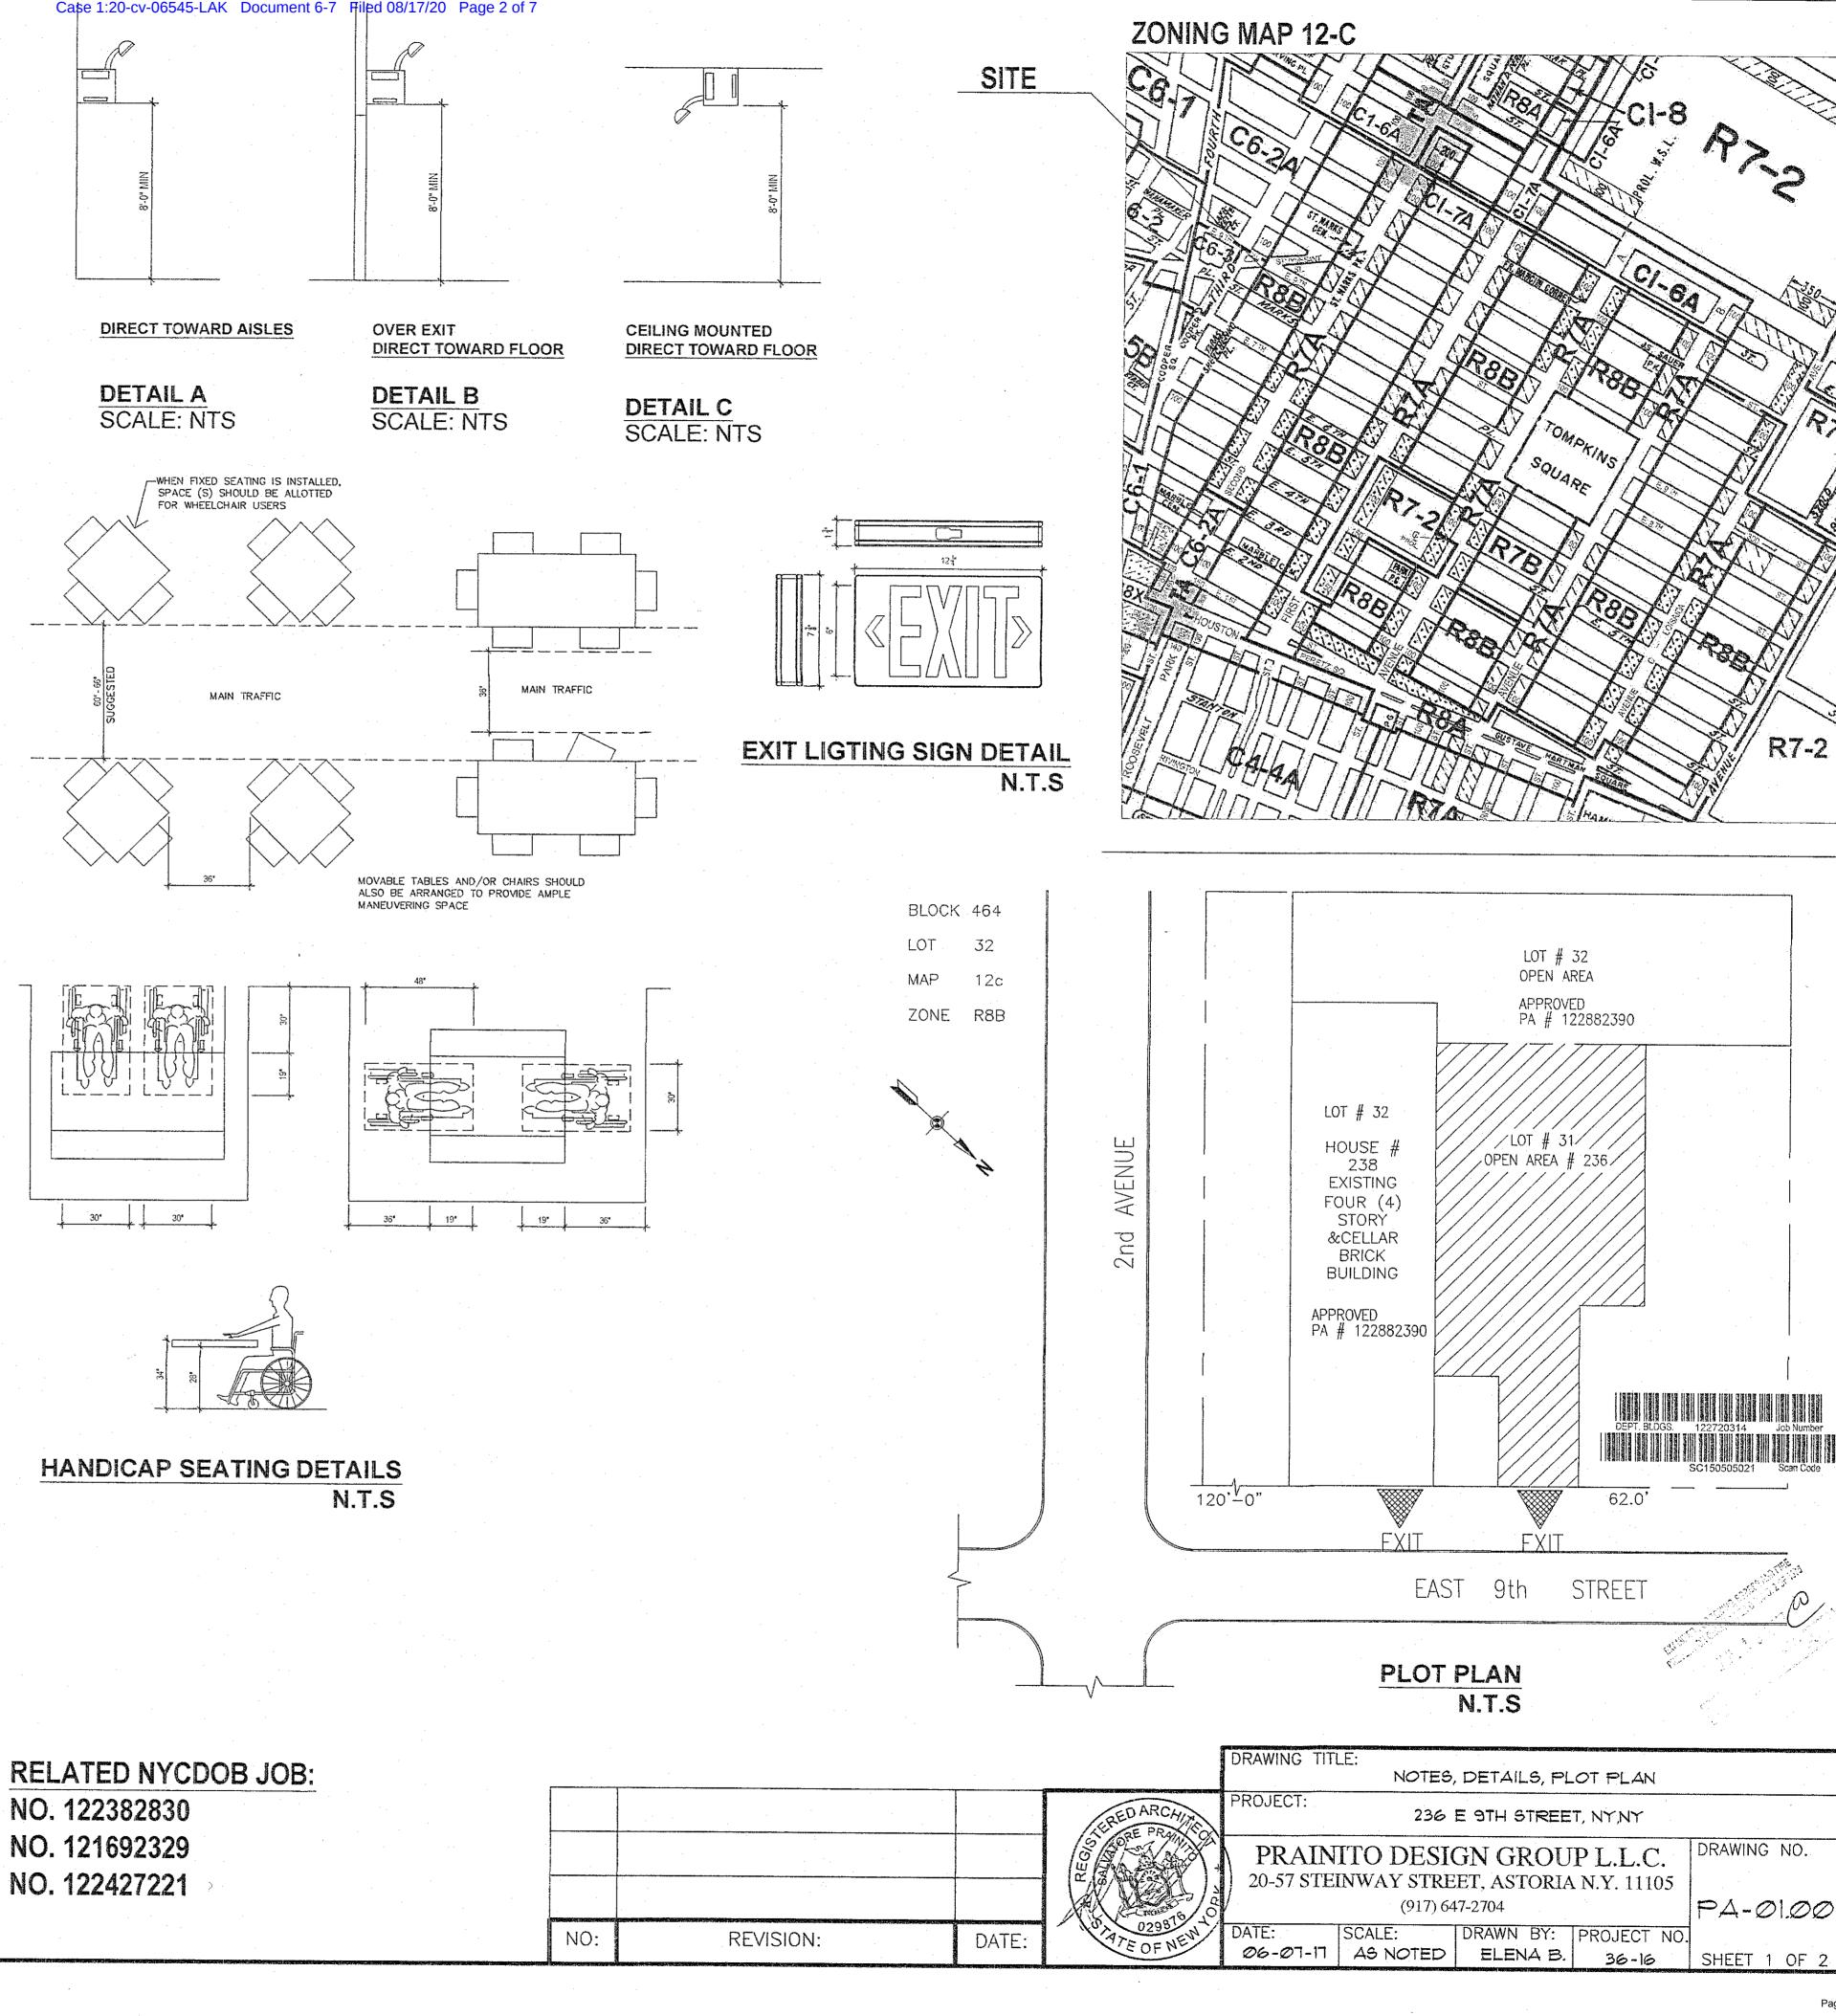

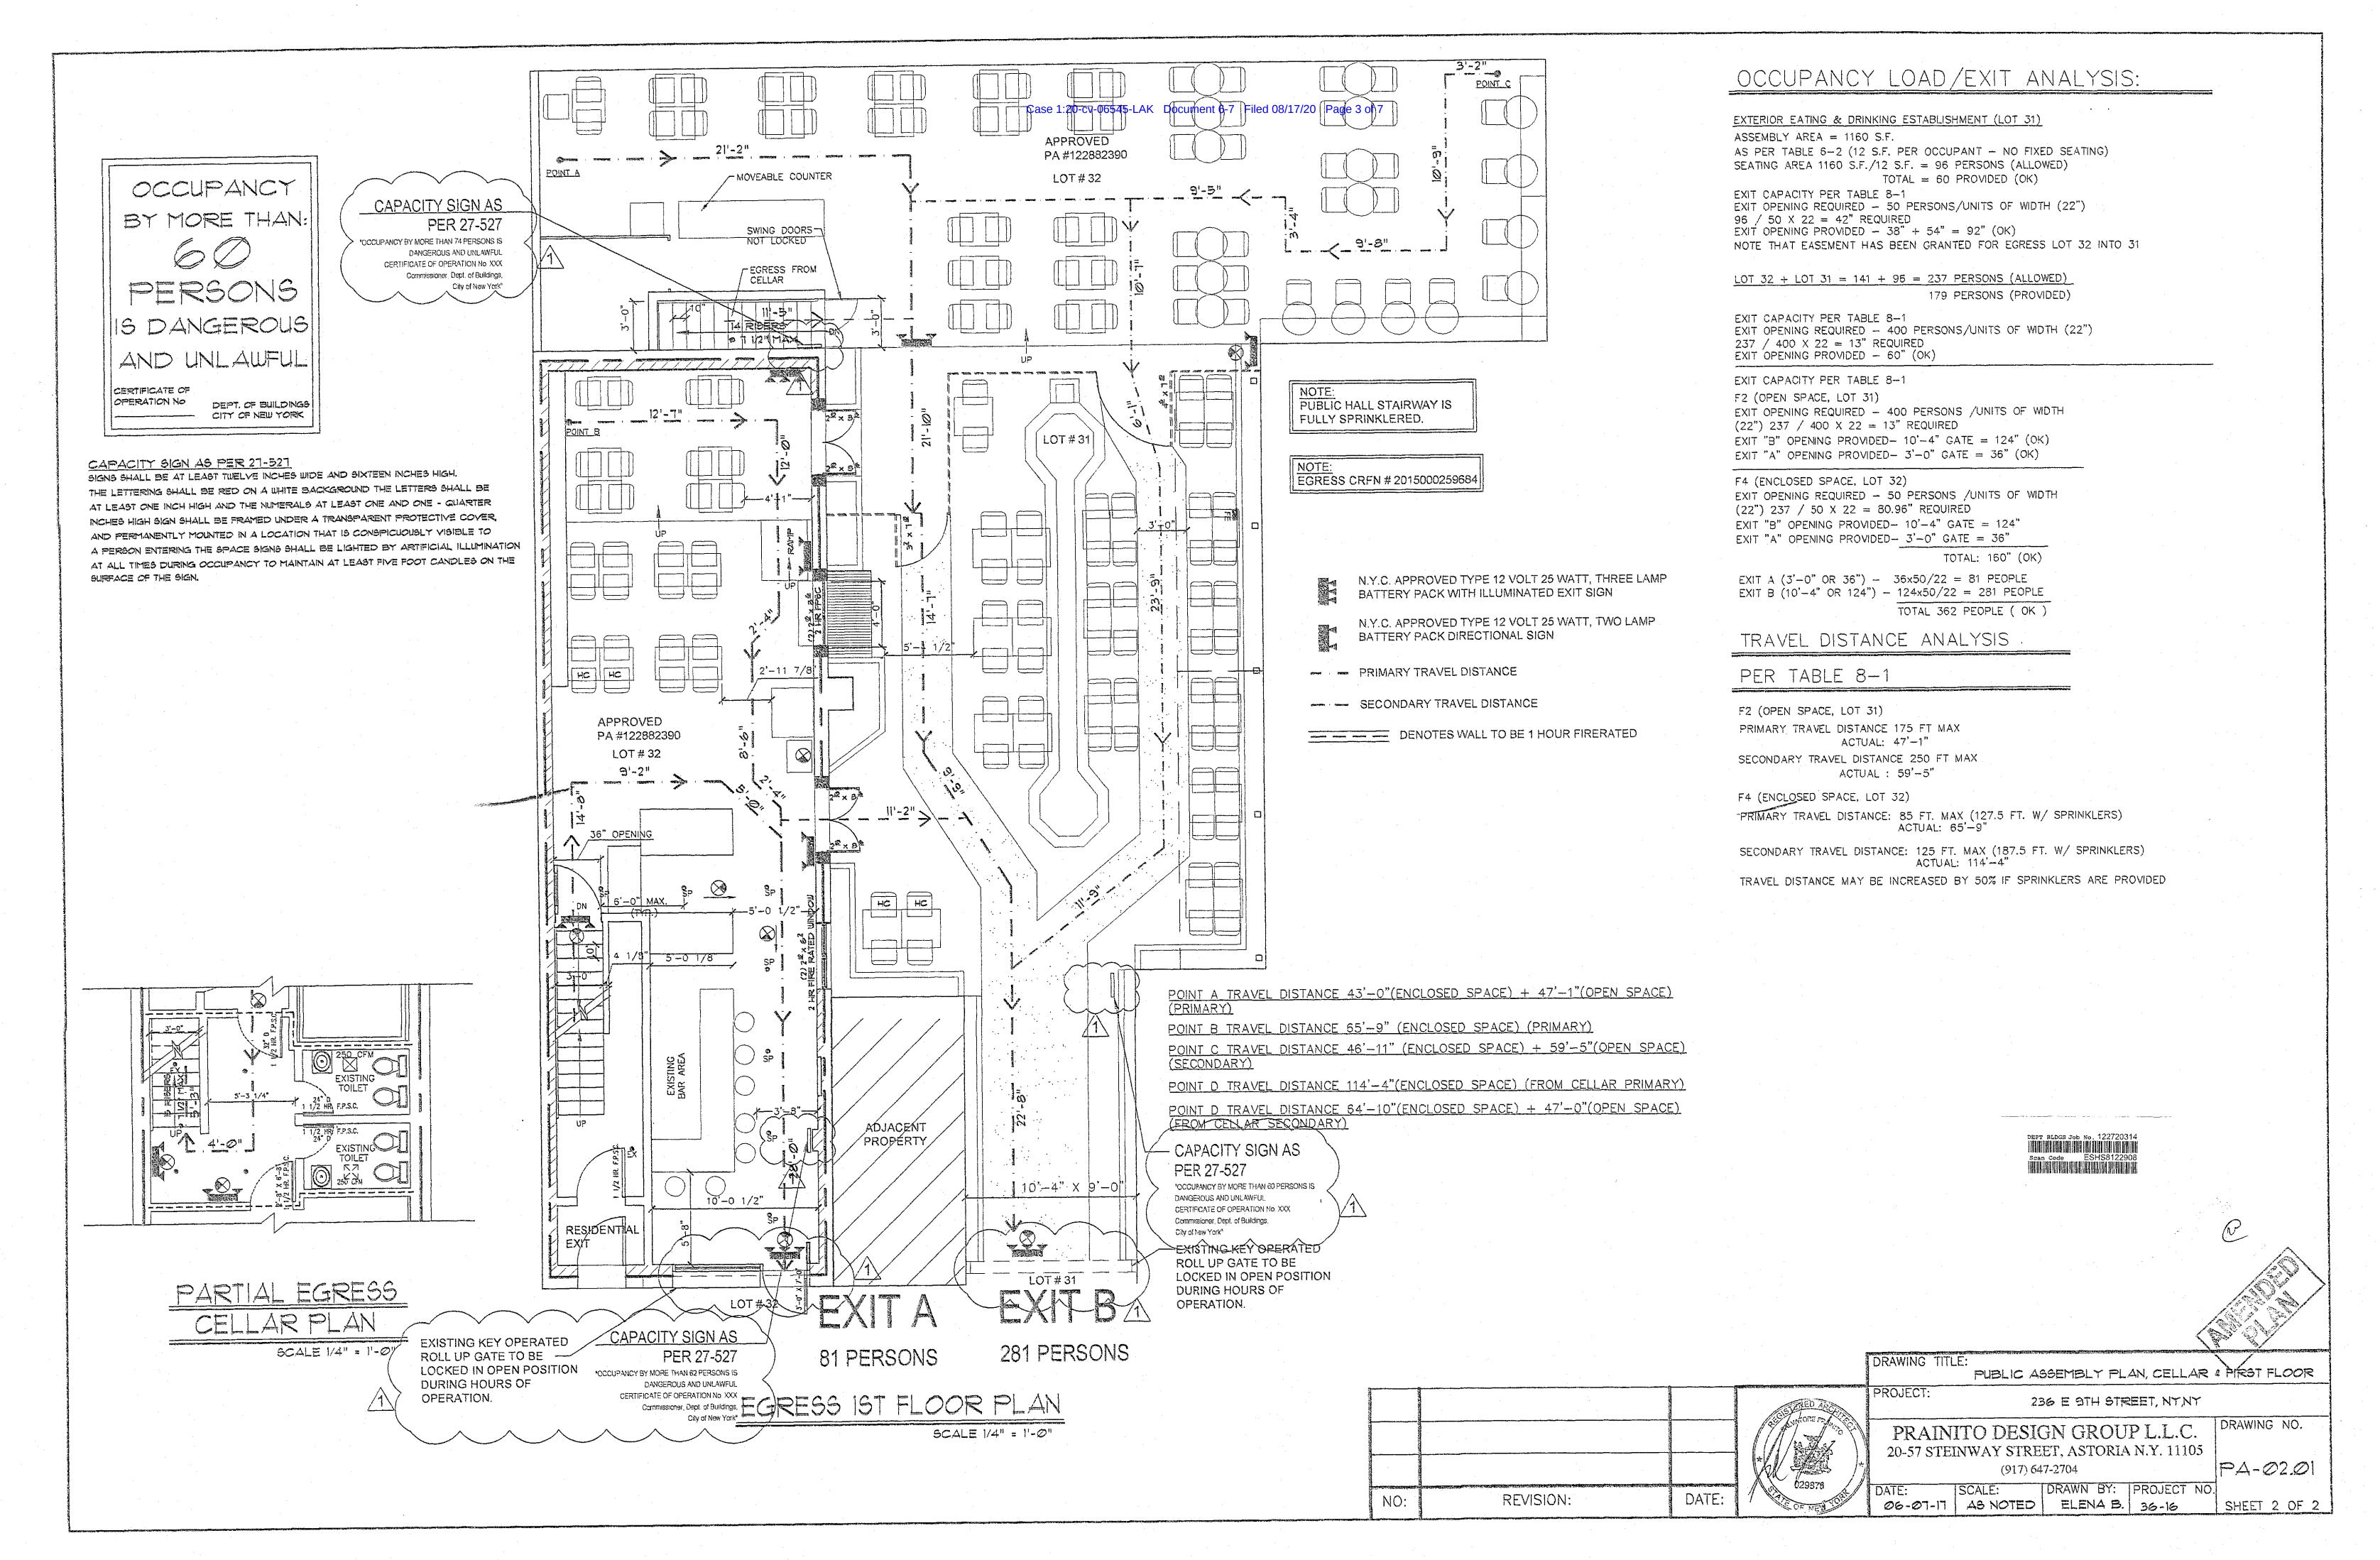

Page 3 of 7

## 

## 238 EAST 9TH STREET, NEW YORK, NEW YORK

GENERAL NOTES:

1. THE GENERAL CONTRACTOR SHALL FURNISH ALL LABOR MATERIALS, TOOLSAND EQUIPMENT REQUIRED TO PERFORM ALL WORK AS SHOWN ON THECONSTRUCTION DRAWINGS AND SPECIFIED HEREIN. IN GENERAL THE WORK SHALL INCLUDE BUT NOT NECESSARY LIMITED TO WORK SPECIFIED

2. THE CONTRACTOR SHALL VERIFY ALL MEASUREMENTS AND CONDITIONS IN THE

3. THE CONTRACTOR SHALL BE GUIDED AT ALL TIMES BY DIMENSIONS SHOWN ON PLANS AND NOT BY SCALE OF DRAWINGS. THE CONTRACTOR SHALL CONSULTHE ARCHITECT IN CASE OF ANY DISCREPANCIES.

4. THE CONTRACTOR SHALL PERFORM ALL WORK IN ACCORDANCE WITH THE REQUIREMENTS OF NEW YORK CITY CONSTRUCTION CODE, MULTIPLE DWELLING LAW AND OTHER LOCAL & FEDERAL LAWS AND ORDINANCES. 5. BATHROOM VENTILATED BY MECHANICAL MEANS SHALL

HAVE 1 AIR SPACEBETWEEN BOTTOM AND THRESHOLD OF 6. ALL GYPSUM BOARDS IN BATHROOMS TO BE

WATER-RESISTANT TYPE 7. ALL NEW WALLS TO BE TAPED AND SPECKLED WITH 3

COATS READY FOR PAINTING. 8. GAS RANGES TO BE A.G.A. APPROVED TYPE. 9. PROVIDE ONE LAYER OF \$" TYPE 'X' GYPSUM BOARD

BEHIND GAS-RANGEFOR FIRE RETARDATION.

1. ALL PIPING LAYOUTS ARE DIAGRAMMATIC AND ALL WORK SHALL BE INSTALLED MEET JOB CONDITIONS.

2. ALL PIPING TO BE INSTALLED TO MEET JOB CONDITIONS, ALL PIPING TO BE INSTALLED UNDERGROUND AND BEHIND FINISH LINES OF FLOORS, WALLS, AND CEILING EXCEPT WHEN APPROVED BY THE ARCHITECT. 3. ALL PIPING WORK WILL BE EXECUTED BY A LICENSED PLUMBER AND IN ACCORDANCE WITH THE NEW YORK CITY 2008 PLUMBING CODE AND OTHER

LOCAL & FEDERAL LAWS AND ORDINANCES 4. ALL NEW SOIL AND WASTE AND STORM LEADER TO BE CAST IRON. SOIL AND WASTE AS PER CODE AND RISER DIAGRAM 5. ALL NEW VENTING ABOVE GROUND COMPLY WITH NYC PC 702 TABLE 702.1. VENTING BELOW GROUND COMPLY WITH NYC PC 702 TABLE 702.2 6. WATER SUPPLY & DISTRIBUTION MATERIAL SHALL CONFORM TO SECT. PC 60

AND TABLES 605.3 & 605.4 7. WATER SUPPLY CONTROL VALVES TO BE INSTALLED AT EACH SUPPLY BRANCH TO THE GROUP OF FIXTURES AND TO SUPPLY BRANCHES OF INDIVIDUAL FIXTURES. ALL WATER CONTROL VALVES SHALL BE PLACED AS TO BE READILY ACCESSIBLE FROM SERVICE AND MAINTENANCE, PC 603 & PC 604 8. PLUMBING FIXTURES MATERIAL SHALL COMPLY WITH SEC. PC 402 A. WATER CLOSET OF VITREOUS CHINA

B. ALL OTHER FIXTURES TO BE IRON ENAMEL C. ALL FIXTURES TO BE SELECTED BY OWNER/CONTRACTOR AND ARCHITECT PLUMBING WASTE AND STACKS SHALL BE PROVIDED WITH CLEANOUTS AT THEIR BASE, CLEANOUTS SHALL BE SET AS PER SEC. PC 708

10. BATHROOMS AND TOILETS SHALL HAVE CERAMIC TILE FLOOR WITH 6" BASE TUBS SHALL HAVE 5 FEET HIGH CERAMIC TILE. CERAMIC TILE SHALL EXTEND ON COURSE ABOVE SHOWER HEAD. WATER CLOSET SHALL COMPLY WITH LL 11. ALL BATHROOMS RECESSED OR OTHERWISE, SHALL BE PROVIDED WITH

SUFFICIENT CURTAIN RODS. 12, CARPENTER SHALL PROVIDE FRAMING & RECESS FOR MEDICINE CARINET. DEMOLITION NOTES:

. THE WATER & GAS SUPPLY MUST BE DISCONNECTED PRIOR TO DEMOLITION

OF ALL WORK ON PIPING AND EQUIPMENT PIPING. FLOOR DRAINS AND PLUMBING FIXTURES 2. ALL UNUSED PLUMBING AND EQUIPMENT LINES MUST BE REMOVED AND CAPPED AT THE MAIN RISER OR BRANCH

3. ALL EXISTING MASONRY CONSTRUCTION SUCH AS COLUMNS, PIERS AND CORE PARTITIONS, WHERE DISTURBED DUE TO ADJACENT DEMOLITION, SHALL BE REPAIRED OR REPLACED WITH MATERIALS MATCHING EXISTING CONSTRUCTION. MASONRY OPENINGS MUST BE FILLED WITH

THE SAME MATERIALS BEFORE DRYWALL IS APPLIED. REMOVE ALL ELECTRICAL CABINETS AND CONDUIT BACK

5. FIRE SAFETY MUST BE MAINTAINED FOR ALL PERSONNEL WORKING ON THE FLOOR. WHERE DEMOLITION IS TO TAKE PLACE IN THE AREA OF THE BUILDING, WHERE

FIRE SAFETY EQUIPMENT SUCH AS FIRE ALARM, SPRINKLER, SMOKE DETECTORS, FLOOR WARDEN STATIONS, ETC. ARE LOCATED, THE BUILDING MANAGER MUST BE NOTIFIED (3) THREE DAYS PRIOR OF COMMENCEMENT OF WORK, SO THAT SUCH EQUIPMENT MAY BE PROTECTED OR REMOVED. ALL SAFETY EQUIPMENT AND ASSOCIATED CONDUIT AND

VIRING SYSTEMS SHALL NOT BE HARMED DURING DEMOLITION AND OR CONSTRUCTION AND SHALL BE PROTECTED FROM PHYSICAL DAMAGE. . THE DEMOLISHED WORK AND DEBRIS MUST BE REMOVED SO IT WILL PERMIT FOR A NEW MATERIALS AND EQUIPMENT

TO BE PROPERLY INSTALLED. CARE IN REMOVAL OF WORK AND CLEAN UP

1. ALL REMOVAL SHALL BE PERFORMED IN KEEPING WITH THE BEST SAFETY PRACTICE GOVERNING THE SAME IN ACCORDANCE WITH ALL CITY, STATE AND/OR FEDERAL LAWS GOVERNING THE SAME

2. ALL DEBRIS RESULTING FROM THE OPERATION UNDER THIS CONTRACT SHALL BE REMOVED FROM THE SITE AND SHALL NOT BE STORED OR PERMITTED TO ACCUMULATE ON THE SITE . UPON COMPLETION OF WORK UNDER THIS

CONTRACT. THE CONTRACTOR SHALL NOT REMOVE ALL TOOLS, EQUIPMENT, MATERIALS, APPARATUS ETC. AND SHALL LEAVE THE PREMISES CLEAN NEAT AND ORDERLY. PREMISES SHALL BE BROOM SWEPT OR VACUUMED.

SMOKE DETECTOR NOTES (BC907.2.10) LISTED SINGLE-OR MULTIPLE STATIONS SMOKE DETECTORS SHALL BE INSTALLED AND MAINTAINED IN ACCORDANCE WITH PROVISIONS OF BC &  $\underline{\mathsf{LOCATION}}: \mathsf{IN}$  EVERY DWELLING UNIT (R-2) REGARDLESS OF OCCUPANCY LOAD AS FOLLOWS: ON THE CEILING OR WALL OUTSIDE OF EACH ROOM USED FOR

SLEEPING PURPOSES AND WITHIN 15 FEET FROM THE DOOR OF SUCH IN EACH ROOM USED FOR SLEEPING PURPOSES. 5. IN EACH STORY WITHIN A DWELLING UNIT, INCLUDING BELOW-GRADE STORIES AND PENTHOUSE OF ANY AREA, BUT NOT INCLUDING CRAWL SPACES AND UNINHABITABLE ATTICS. IN DWELLING OR DWELLING UNITS WITH SPLIT LEVELS AND WITHOUT INTERVENING DOOR BETWEEN THE ADJACENT, A SMOKE ALARM INSTALLED ON UPPER LEVEL HALL SUFFICE FOR THE ADJACENT LOWER LEVEL PROVIDED THAT THE LOWER LEVEL IS LESS ONE FULL STORY BELOW THE UPPER LEVEL(BC 907.2.10.1.1) POWER SOURCE: REQUIRED SMOKE ALARMS SHALL RECEIVE THEIR PRIMARY POWER FROM A DEDICATED BRANCH CIRCUIT OR THE UNSWITCHED PORTION OF THE BRANCH CIRCUIT ALSO USED FOR POWER AND LIGHTING AND SHALL BE EQUIPPED WITH A BATTERY BACKUP, SMOKE ALARMS SHALL EMIT A SIGNAL WHEN THE BATTERIES ARE LOW, WIRING SHALL BE PERMANENT AND WITHOUT DISCONNECTING SWITCH OTHER THEN AS REQUIRED FOR

OVER-CURRENT PROTECTION. (BC 097.2.10.2)

I<u>INTERCONNECTION:</u> WHERE MORE THEN ONE SMOKE DETECTOR IS REQUIRED TO BE INSTALLED WITHIN INDIVIDUAL DWELLING UNIT IN GROUP R-2,R-3 OR WITHIN AND INDIVIDUAL DWELLING UNIT OR SLEEPING UNIT IN GROUP R-1. SMOKE DETECTORS SHALL BE INTERCONNECTED IN SUCH MANNER THAT THE ACTIVATION OF ONE DETECTOR WILL ACTIVE ALL OF THE DETECTORS IN THE DWELLING UNIT.THE DETECTOR SHALL BE CLEARLY AUDIBLE IN ALL BEDROOMS OVER BACKGROUND NOISE EVELS WITH ALL INTERVENING DOOR. G: WHEN THE INSTALLATION OF THE ALARM DEVICES IS COMPLETE, EACH ESTING: WHEN THE INSTALLATION OF THE ACCUMULATIVE STATION ALARM DEVICES DETECTOR AND INTERCONNECTING WIRING FOR MULTIPLE—STATION ALARM DEVICES

SHALL BE TESTED IN ACCORDANCE WITH THE HOUSEHOLD FIRE WARRING EQUIPMENT PROVISION OF NFPA 72 (8C907.2.10.4) VISIBILITY: SMOKE DETECTORS SHALL BE PROVIDED WITH THE CAPABILITY TO SUPPORT VISIBLE ALARM NOTIFICATION APPLICATIONS IN ACCORDANCE WITH ICC/ANSI 117.1 (BC907.2.10.5)

CARBON MONOXIDE DETECTOR NOTES

EVERY DWELLING UNIT SHALL BE EQUIPPED WITH AN OPERATIONAL AND APPROVED TYPE CARBON MONOXIDE DETECTOR DEVICES RECEIVING PRIMARY POWER FROM THE BUILDING WIRING WITH NO SWITCHES IN THE CIRCUIT OTHER THAN THAT OVER CURRENT DEVICE PROTECTING THE BRANCHOLD WITH MITHER CONTROL OF THE PROTECTING THE BRANCHOLD WITH MITHER CONTROL OF THE PROTECTION OF THE PROTEC CIRCUIT WITH SECONDARY BATTERY BACK-UP IN COMPLIANCE MONOXIDE DETECTORS MUST BE INSTALLED WITHIN 15'-0" OF THE ENTRANCE OF ANY SLEEPING ROOM, WALL OR CEILING MOUNTED AND INDICATED ON PLAN. SUCH CARBON MONOXIDE DETECTING DEVICE MAY BE COMBINED WITH SMOKE DETECTING DEVICE THAT COMPLIES WITH THE PROVISIONS OF CHAPTER 9 OF 2008 NYC BUILDING CODE

TENANT PROTECTION PLAN (2008 CODE - 28-104.8.4)

AT ALL TIMES IN THE COURSE OF CONSTRUCTION PROVISION SHALL BE MADE FOR ADEQUATE EGRESS AS REQUIRED BY THIS CODE AND TENANT PROTECTION PLAN SHALL IDENTIFY THE EGRESS THAT WILL BE PROVIDED REQUIRED EGRESS MUST NOT BE OBSTRUCTED AT ANY TIME. EXCEPT WHERE APPROVED BY THE COMMISSIONER.

2. FIRE SAFETY ALL NECESSARY LAWS AND CONTROLS INCLUDING THOSE WITH RESPECT TO OCCUPIED DWELLINGS, AS WELL AS ADDITIONAL SAFETY MEASURES NECESSITATED BY THE CONSTRUCTION SHALL BE STRICTLY OBSERVED.

3. HEALTH REQUIREMENTS SPECIFICATION OF METHODS TO BE USED FOR CONTROL OF DUST, DISPOSAL OF CONSTRUCTION DEBRIS PEST CONTROL
AND MAINTENANCE OF SANITARY FACILITIES AND LIMITATION
OF NOISE TO ACCEPTABLE LEVELS SHALL BE INCLUDED.
3.1. THERE SHALL BE INCLUDED A STATEMENT OF COMPLIANCE
WITH APPLICABLE PROVISIONS OF LAW RELATING TO LEAD AND ASBESTOS.

4. COMPLIANCE WITH HOUSING STANDARDS THE REQUIREMENTS OF THE NEW YORK CITY HOUSING MAINTENANCE CODE. AND. WHERE APPLICABLE, THE NEW YORK STATE MULTIPLE DWELLING LAW SHALL BE STRICTLY OBSERVED. 5. STRUCTURAL STABILITY

NO STRUCTURAL WORK SHALL BE DONE THAT MAY ENDANGER THE OCCUPANTS. 6. NOISE RESTRICTIONS. WHERE HOURS OF THE DAY OR THE DAYS OF THE WEEK IN WHICH CONSTRUCTION WORK MAY BE UNDERTAKEN ARE LIMITED PURSUANT TO NEW YORK CITY NOISE CONTROL CONTROL CODE, SUCH LIMITATION

SHALL BE STATED.

PLANS SUBMITTED BY APPLICANT SHALL SHOW COMPLIANCE WITH THE ITEMS DURING CONSTRUCTION DETAILS SUCH AS TEMPORARY FIRE—RATED ASSEMBLIES AND OPENING PROTECTION SHALL BE INCLUDED. CONSTRUCTION WORK WILL BE CONFINED TO THE APARTMENT INTERIOR AND WILL NOT CRATE DUST, DIRT, OR OTHER SUCH INCONVENIENCES TO THE OTHER APARTMENT UNITS WITHIN THE BUILDING CONSTRUCTION OPERATIONS WILL NOT INVOLVE INTERRUPTION OF HEATING, WATER OR ELECTRICAL SERVICES

TO OTHER TENANTS OF THE BUILDING MULTIPLE DWELLING LAW AND HOUSING MAINTENANCE CODE PAINTING-(SEC 29 MDL & SUB2 ART.3 HMC) 1. PAINTING OF PUBLIC PARTS AND WITHIN DWELLING SHALL

COMPLY WITH SEC 27-2013 HMC. 2. PAINTING OF WINDOWS FRAMES SHALL COMPLY WITH SEC 3. WALLS OF COURTS AND SHAFTS SHALL BE OF A LIGHT COLORED

SURFACE AS PER 27-2015 HMC. 4. ALL PUBLIC HALLS TO BE PAINTED. EXTERMINATION & RAT PROOFING- (SEC 80 MDL & SUB. 2 ART 4 HMC) . DWELLING SHALL BE CONSTRUCTED AS TO BE RAT-PROOF.

PREMISES SHALL BE MAINTAINED AND KEPT FREE OF RODENT AND INSECT INFESTATION. RECEPTACLES FOR COLLECTION OF WASTE MATTER - (SEC B1 MDL & SUB. 2 ART, 5 HMC) 1. PROPER AND SUITABLE CONVENIENCE OR RECEPTACLES SHALL BE PROVIDED FOR COLLECTION OF WASTE MATTER.

ARTIFICIAL LIGHTING- (SEC 26 & 35 MDL & SUB. 2 ART 10 HMC) 1. PROPER ELECTRIC LIGHTING AND EQUIPMENT SHALL BE PROVIDED AND MAINTAINED WITH ALL DWELLINGS. PROPER ELECTRIC LIGHTS SHALL BE INSTALLED AND MAINTAINED AT OR NEAR THE OUTSIDE FRONT ENTRANCE, WAY AND IN EVERY REAR YARD, SIDE YARD, FRONT YARD AND COURTS. MINIMUM OF 50 WATTS INCANDESCENT ILLUMINATION OR EQUIVALENT AT FRONT ENTRANCE WAY AND MINIMUM OF 40 WATTS IN YARDS AND COURTS

SHALL BE KEPT BURNING FROM SUNSET EACH DAY TO SUNRISE 3. ILLUMINATION OR EQUIVALENT AT FRONT ENTRANCE WAY AND MINIMUM OF 40 WATTS IN YARDS AND COURT SHALL BE KEPT BURNING FROM SUNSET EACH DAY TO SUNRISE THE FOLLOWING DAY. ENTRANCE DOORS- (SEC 50 - A ML & SUB. 2 ART 11 HMC) 1. BUILDING ENTRANCE AND ALL OTHER EXTERIOR ENTRANCE SHALL

BE EQUIPPED WITH APPROVED TYPE AUTOMATIC SELF-CLOSING AND SELF—LOCKING DOORS. 2. ENTRANCE DOORS TO EACH DWELLING UNIT SHALL HAVE KEY LOCK WITH AT LEAST ONE KEY TO BE PROVIDED BY OWNER.

3. CLASS A MULTIPLE DWELLING CONTAINING EIGHT OR MORE APARTMENTS SHALL BE EQUIPPED WITH APPROVED TYPE INTER-COMMUNICATION SYSTEM LOCATED AT THE DOOR GIVING ACCESS TO THE MAIN ENTRANCE HALL OR LOBBY 4. MAIN ENTRANCE AND VESTIBULE DOORS SHALL HAVE NOT LESS THAN FIVE (5) SQ.FT. OF GLAZED SURFACE.

5. PEEPHOLES SHALL BE PROVIDED IN ENTRANCE DOORS OF EACH DWELLING UNIT, LOCATED AS PRESCRIBED BY THE DEPARTMENT. SECURITY REQUIREMENTS BUILDING ENTRANCE DOORS AND OTHER EXTERIOR DOORS SHALL PROVIDED WITH HEAVY DUTY LOCK SETS WITH AUXILIARY LATCH BOLTS TO PREVENT THE LATCH FROM BEING MANIPULATED BY OTHER THAN A KEY.

2. DOOR TO DWELLING UNITS SHALL BE EQUIPPED WITH A HEAVY DUTY LOCK SETS, A DEAD BOLT OR AUXILIARY LATCH AND A CHAIN DOOR GUARD. 3. ALL OPERABLE WINDOWS SHALL BE EQUIPPED WITH SASH LOCKS DESIGNED TO BE

OPERABLE FROM THE INSIDE ONLY. 4. BUILDING CLASSIFIED IN OCCUPANCY GROUP J-2 (R-2) CONTAINING EIGHT OR MORE DWELLING UNITS SHALL BE PROVIDED WITH AN INTER-COMMUNICATION SYSTEM LOCATED AT THE DOOR GIVING ACCESS TO THE

- (SEC. 64 MDL & SUB.2 ART 9 HMC) GAS APPLIANCES . METERS SHALL COMPLY WITH SEC. MDL. GAS APPLIANCE SHALL COMPLY WITH THE BOARD OF STANDARDS &

REGISTRATION 1. REGISTRATION STATEMENT SHALL BE FILED. 2. REGISTRATION IDENTIFICATION SIGN CONTAINING DWELLING SERIAL NUMBER SHALL BE POSTED IDENTIFICATION OF MANAGING AGENT OR OWNER SHALL BE INDICATED ON TENANTS RENT RECEIPT 4. PREMISES TO COMPLY WITH APPLICABLE SECTIONS OF MDL.

HOUSING MAINTENANCE CODE & LL76/68 AS AMENDED.

BELLS AND MAIL SERVIGE(SEC 57 MDL & ART 21 HMC) 1. BELL OR BUZZER SYSTEM SHALL BE APPROVED TYPE AND SHALL BE KEPT TO GOOD WORKING ORDER. 2. PROVIDE AND MAINTAIN APPROVED TYPE MAIL RECEPTACLES AND DIRECTORIES OF PERSONS LIVING IN BUILDING AS PROVIDED BY FEDERAL LAW AND AS PER REGULATIONS OF THE POST OFFICE DEPT. MAIL BOXES TO BE READILY ACCESSIBLE TO MAILMAN.

FLOOR SIGNS AND STREET NUMBERS - (ART 21 HMC) . PROPER FLOOR SIGNS SHALL BE PROVIDED AND MAINTAINED IN PUBLIC HALL NEAR STAIRS AND ELEVATORS WITHIN STAIR ENCLOSURE. 2. PROPER STREET NUMBERS SHALL BE POSED AND

MAINTAINED IN FRONT OF THE DWELLING IN ACCORDANCE WITH THE ADMINISTRATIVE CODE AND THE RULES AND REGULATIONS OF THE BOROUGH PRESIDENT. KITCHENS AND KITCHENETTES - (SEC 33 MDL AND ART 32 HMC)

AND ELECTRICITY OR BOTH FOR COOKING AND SHALL BE EQUIPPED FOR ARTIFICIAL LIGHTING 2. KITCHENETTES SHALL BE PROVIDED WITH A SINK HAVING A MIN 2" WASTE TRAP. 3. CEILINGS AND WALLS OF ALL KITCHENETTES SHALL BE FIRE

1. EVERY KITCHEN AND KITCHENETTE SHALL BE PROVIDED WITH GAS

RETARDED WITH MATERIAL HAVING A ONE HOUR FIRE RATING. 4. KITCHENETTES SHALL BE PROVIDED WITH MECHANICAL VENTILATION WHICH WILL PROVIDE AT LEAST 6 CHANGES OF AIR PER HOUR, BUT NOT LESS THAN 100 CFM AS PER BC 1204 AND CHAPTER 4 SECTION 403 & TABLE 403.3 OF 2008 NYC MECHANICAL CODE WATER CLOSET AND BATHROOMS- (SEC. 76 MDL & ART. 31.HMC) 1. WALLS AND FLOORS OF WATER CLOSET COMPARTMENTS,

BATHROOMS AND LAVATORIES SHALL COMPLY WITH REQUIREMENTS OF THESE SECTIONS. 2. EVERY WATER CLOSED COMPARTMENT, BATHROOM OR LAVATORY SHALL HAVE MECHANICAL VENTILATION WHICH WILL PROVIDE AT LEAST FOUR CHANGES OF AIR PER HOUR OR A MIN. OF 50 CU.FT. OF AIR FOR EACH SUCH WATER CLOSET COMPARTMENT, BATHROOM OR LAVATORY OR SHALL BE PROVIDED WITH APPROVED TYPE REGISTER AND TENANT. OPERATED FAN WITH FUSIBLE LINK DAMPER B.S.A. CAL.# 638-41-SM

3. BATHROOM AND LAVATORIES SHALL HAVE CERAMIC TILE FLOOR AND 6" BASE. CERAMIC TILE 6' HIGH ON WALLS OF SHOWERS AT TUBS AND OR STALL SHOWERS. 4. MOISTURE RESISTANT GYPSUM BOARD ON WALLS BSA CAL.# 756-62-SM LAUNDRY ROOM

5. LAUNDRY SHALL BE FOR TENANT'S USE ONLY. MACHINES SHALL BE APPROVED SELF-SERVICE TYPE. NO EMPLOYEES SHALL ENGAGE IN OPERATION OF EXTRACTORS OR DRYERS. PLUMBING AND DRAINAGE - (SEC. 77 MDL & ART 16HMC) . ENTIRE PLUMBING AND DRAINAGE SYSTEM INCLUDING A

PLUMBING FIXTURES SHALL BE PROPERLY MAINTAINED AND KEPT IN GOOD REPAIR AT ALL TIMES. 2. ALL ROOFS, TERRACES, SHAFTS, COURTS, AREAS AND YARDS SHALL BE PROPERLY GRADED AND DRAINED (SEE SITE PLAN) HEAT AND HOT WATER - (SEC. 79 MDL & ART 17 HMC)

1. YEARLY INSPECTIONS OF CENTRAL HEATING PLANTS SHALL BE MADE BY QUALIFIED PERSONS 2. MINIMUM TEMPERATURES FOR HEATING AND HOT WATER SHALL BE

3. BOILER ROOM TO COMPLY WITH SEC 65 MDL RULES AND

NYC DOB PLUMBING NOTES:

THE PLUMBING SYSTEMS (SANITARY, WASTE, VENT. WATER DISTRIBUTION AND GAS) AND ALL ASSOCIATED EQUIPMENT WILL BE INSTALLED AND MAINTAINED IN ACCORDANCE WITH THE FULL REQUIREMENTS OF THE NEW YORK CITY 2008

THE SANITARY SYSTEM SHALL BE PROVIDED IN FULL ACCORDANCE WITH THE GENERAL PROVISIONS OF SECTION PC 301. THE MATERIALS USED IN THE PLUMBING SYSTEMS WILL

FULL ACCORDANCE WITH THE SECTIONS PC 302 & PC 303 3. EQUIPMENT HOOK-UP AND THE JOINING WILL BE IN FULL COMPLIANCE WITH

THE SECTIONS PC605 &PC 705 4. THE INSTALLATION OF FIXTURES WILL BE IN FULL ACCORDANCE WITH PC TRAPS FOR FIXTURES AND DRAIN LINES WILL BE

PROVIDED AND CLEANOUTS INSTALLED IN FULL COMPLIANCE WITH THE SECTIONS PC 412, PC 708 & PC VERTICAL AND HORIZONTAL PIPING WILL BE HUNG AND SUPPORTED AS DIRECTED IN SPECIFICATIONS AND WITH THE FULL

COMPLIANCE WITH SECTION THE WATER SUPPLY SYSTEMS OF THE SUBJECT BUILDING INSTALLED AND MAINTAINED IN FULL COMPLIANCE WITH PC CHAPTER 6

8. THE SANITARY DRAINAGE SYSTEM WILL BE SIZED AND INSTALLED IN FELL COMPLIANCE WITH PC CHAPTER 7. THE VENT PIPING FOR THE SANITARY DRAINAGE SYSTEM OF THE SUBJECT BUILDING WILL BE INSTALLED IN FULL COMPLIANCE WITH

SECTION PC 702 & C CHAPTER 9. THE STORM DRAINAGE SYSTEM AND PIPING WILL BE INSTALLED IN FULL COMPLIANCE WITH PC CHAPTER 11 GAS PIPING AND EQUIPMENT WILL BE INSTALLED IN FULL

THE NEW YORK CITY 2008 FUEL GAS CODE. 12. ALL TRENCHING SHALL BE DONE IN FULL ACCORDANCE REQUIREMENTS OF SECTION PC 306. 13. RAT PROOFING SHALL BE PROVIDED IN FULL

ACCORDANCE WITH THE

SECTION PC 304 14. TEMPORARY TOILET FACILITIES SHALL BE PROVIDED FOR WORKMEN AS PER SECTION PC 311.

15. NOT WITHSTANDING ABOVE STATEMENTS. THE WORK SHALL BE LIMITED TO THE SCOPE SPECIFIED IN CONSTRUCTION DOCUMENTS. ZONING ANALYSIS (EXSITING) THE CLOISTER CAFE

LOCATED AT: 238 EAST 9TH STREET, NEW YORK, NY 10003

Case 1:20-84-06545-LAK Document 6-7 46fed 08/17/20 Page 4 of 7

12c R8B EXISTING USE 1STY GARAGE, UG 16

PROPOSED USE (EATING and DRINKING ESTABLISHMENTS). UG 6 (ZR32-15) (Non conforming use) 

EXISTING LOT AREA 56'X18' + 62'X19 = 2,186 S.F. MINIMUM LOT AREA 1,700 Sq.ft. Per Zoning Lot. (ZR23-32)

MAXIMUM FLOOR AREA RATIO 2.00 (ZR33-121) (FOR COMMERCIAL PORTION)

MAXIMUM FLOOR AREA  $2,186 \times 2 = 4,372 \text{ Sa.ft.}$ MAXIMUM FLOOR AREA RATIO 3.14 X 2.186 = 6.864 Sq.ft. (FOR RESIDENTIAL ONLY) 3.14 (ZR23-142)

TOTAL EXIST'G RESIDENTIAL  $1,014 \times 3 = 3,042 \text{ Sq.ft}$ 3,042< 6,864 (Acceptable)

MINIMUM OPEN 0.S.Reg:6.8% OF F.A.(ZR23-142) SPACE RATIO 2,186x0.068= 148.6 Sa.ft.

EXIST FLOOR AREA (Com)=2,186 Sq.ft.<4,372 Sq.ft. (Acceptable) FOR LOT

FLOOR AREA

MINIMUM LOT WIDTH (ZR23-32)-18FTMINIMUM REQUIRED FRONT (ZR23-632)(ZR35-52) Not Required

(ZR23-462)(ZR33-25) Not MINIMUM REQUIRED SIDE YARD Required. If Open Area is Provided Minimum 8ft Wide is

MINIMUM REQUIRED REAR (ZR23-47) 30ft is required beyond 100ft from corner. For residential portion. (ZR33-26) 20ft required beyond 100ft from corner for

WALL (RESIDENTIAL AND COMMERCIAL PORTIONS)

MAX FAR TOTAL

MAX FAR COMM

MIN OSR

FRONT YARD

SIDE YARD

REAR YARD

MAX FAR RESONTL

CODE

ZR 23-151

ZR 23-151

ZR 23-632

ZR 35-51

ZR 23-462

ZR 33-25

ZR 33-26

MAXIMUM HEIGHT OF FRONT (ZR23-632)(ZR33-431)-85ft or 9 stories whichever is less then 20ft. initial setback on narrow street. Then 2.7 vertical distance to 1 horizontal distance.

commercial portion.

ALTERATION TYPE 1 FOR LOT # 31 IS FILED AND APPROVED UNDER 

3.4

6.8%

NONE

N/A - 8'-0"

30'-0"

\* EXIST'G REAR YARD IS NON-COMPLYING YARD WITH REGARD

AS PER TABLE 3-4 CONSTR CLASS - ID - ROOF ASSEMBLY IHR

TO PERMITTED OBSTRUCTIONS - EXIST'S OBSTRUCTIONS ARE

PUBLIC PARKING/ EATING & DRINKING ESTABLISHMENTS

REQ MAX | EXIST'G

1.39

1.39

Ø

N/A

NONE

N/A

13'-11"

PROPOSED

2.39

139

N/A

NONE

N/A

ENERGY ANALYSIS NYS ECCC CHAPTER 5 CLIMATE ZONE 4A PROPOSED DESIGN VALUE CODE PRESCRIPTIVE ITEM DESCRIPTION VALUE AND CITATION FRENCH DOOR U-0.30, SHGC 0.21 U.-0.55 (SHGC 0.40) 502.3 LIGHTING FIXTURE: MIN. 50% OF LAMPS IN PERMANENTLY INSTALLED LIGHT FIXTURES SHALL BE HIGH-EFFICIENCY LAMPS NYS ECCC SEC. 505.53

PROFESSIONAL STATEMENT: TO THE BEST OF MY KNOWLEDGE, BELIEF AND PROFESSIONAL JUDGMENT, ALL WORK UNDER THIS APPLICATION IS IN COMPLIANCE WITH THE NYCECC. 2014

SALVATORE PRAINITIO R.A.

SPECIAL AND PROGRESS INSPECTIONS

DENERGY CODE COMPLIANCE INSPECTIONS (TR-8)\_\_\_\_\_BC109.35 FENESTRATION THERMAL VALUES & RATING - \_\_\_\_\_IIA3

BLOCK 464 ZONE

REMARKS

EXISTING NON-COMPLYING COVERAGE

CONSTRUCTED PER

MAIN BLOG WAS CONSTRUCTED IN THE 1900'S


AS PER HPD I CARDS

OR LESS ISTY PERMITTED OBSTRUCTION IN

-ADJOINING REAR-MIMIOLOR YARD BSTY KOK LOT # 32 EXISTING 1STY GARAGE (U.G.16) PROPOSED RESTAURANT SEATING AREA (U.G.6) PADUACENT LOT # 31 HOUSE OPEN AREA # 236 238 EXISTING EXISTING PARKING FOUR (4) AREA (U.G.8) STORY PROPOSED  $\overline{\mathcal{O}}$ &CELLAR RESTAURANT BRICK SEATING AREA BUILDING (U.G.6)EXIST/ ADJACENI ÉXÍST'G/ ADJOINING 2STY COM - ADJOINING COMMERCIAL BUILDING

CONC. SIDEWALK NOT PART OF THIS PROJECT

PLOT PLAN

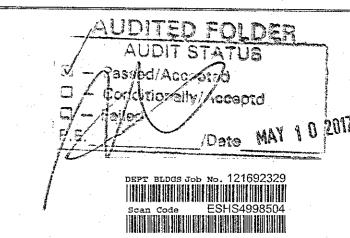

ARTRI

COVER SHEET 238 EAST 9TH STREET, NEW YORK, NY 10003 DRAWING NO. PRAINITO DESIGN GROUP L.L.C. 20-57 STEINWAY STREET, ASTORIA, N.Y. 11105

DRAWN BY: PROJECT NO

SHEET 1 OF 4

Page 4 of 7


(917) 647-2704

06-08-15 AS NOTED | ELENA B. 31-14


in the state of th **AMENDMENT** 05-01-17 **AMENDMENT** 01 - 13 - 1REVISION: DATE:

- ALL PLUMBING WORK TO BE FILED APPLICATION NUMBER 122427221 - ALL KITCHEN EQUIPMENT TO BE FILED UNDER APPLICATION NUMBER 122427221

- FIRE SUPPRESSION ANSUL SYSTEM FILED UNDER APPLICATION NUMBER 122280968

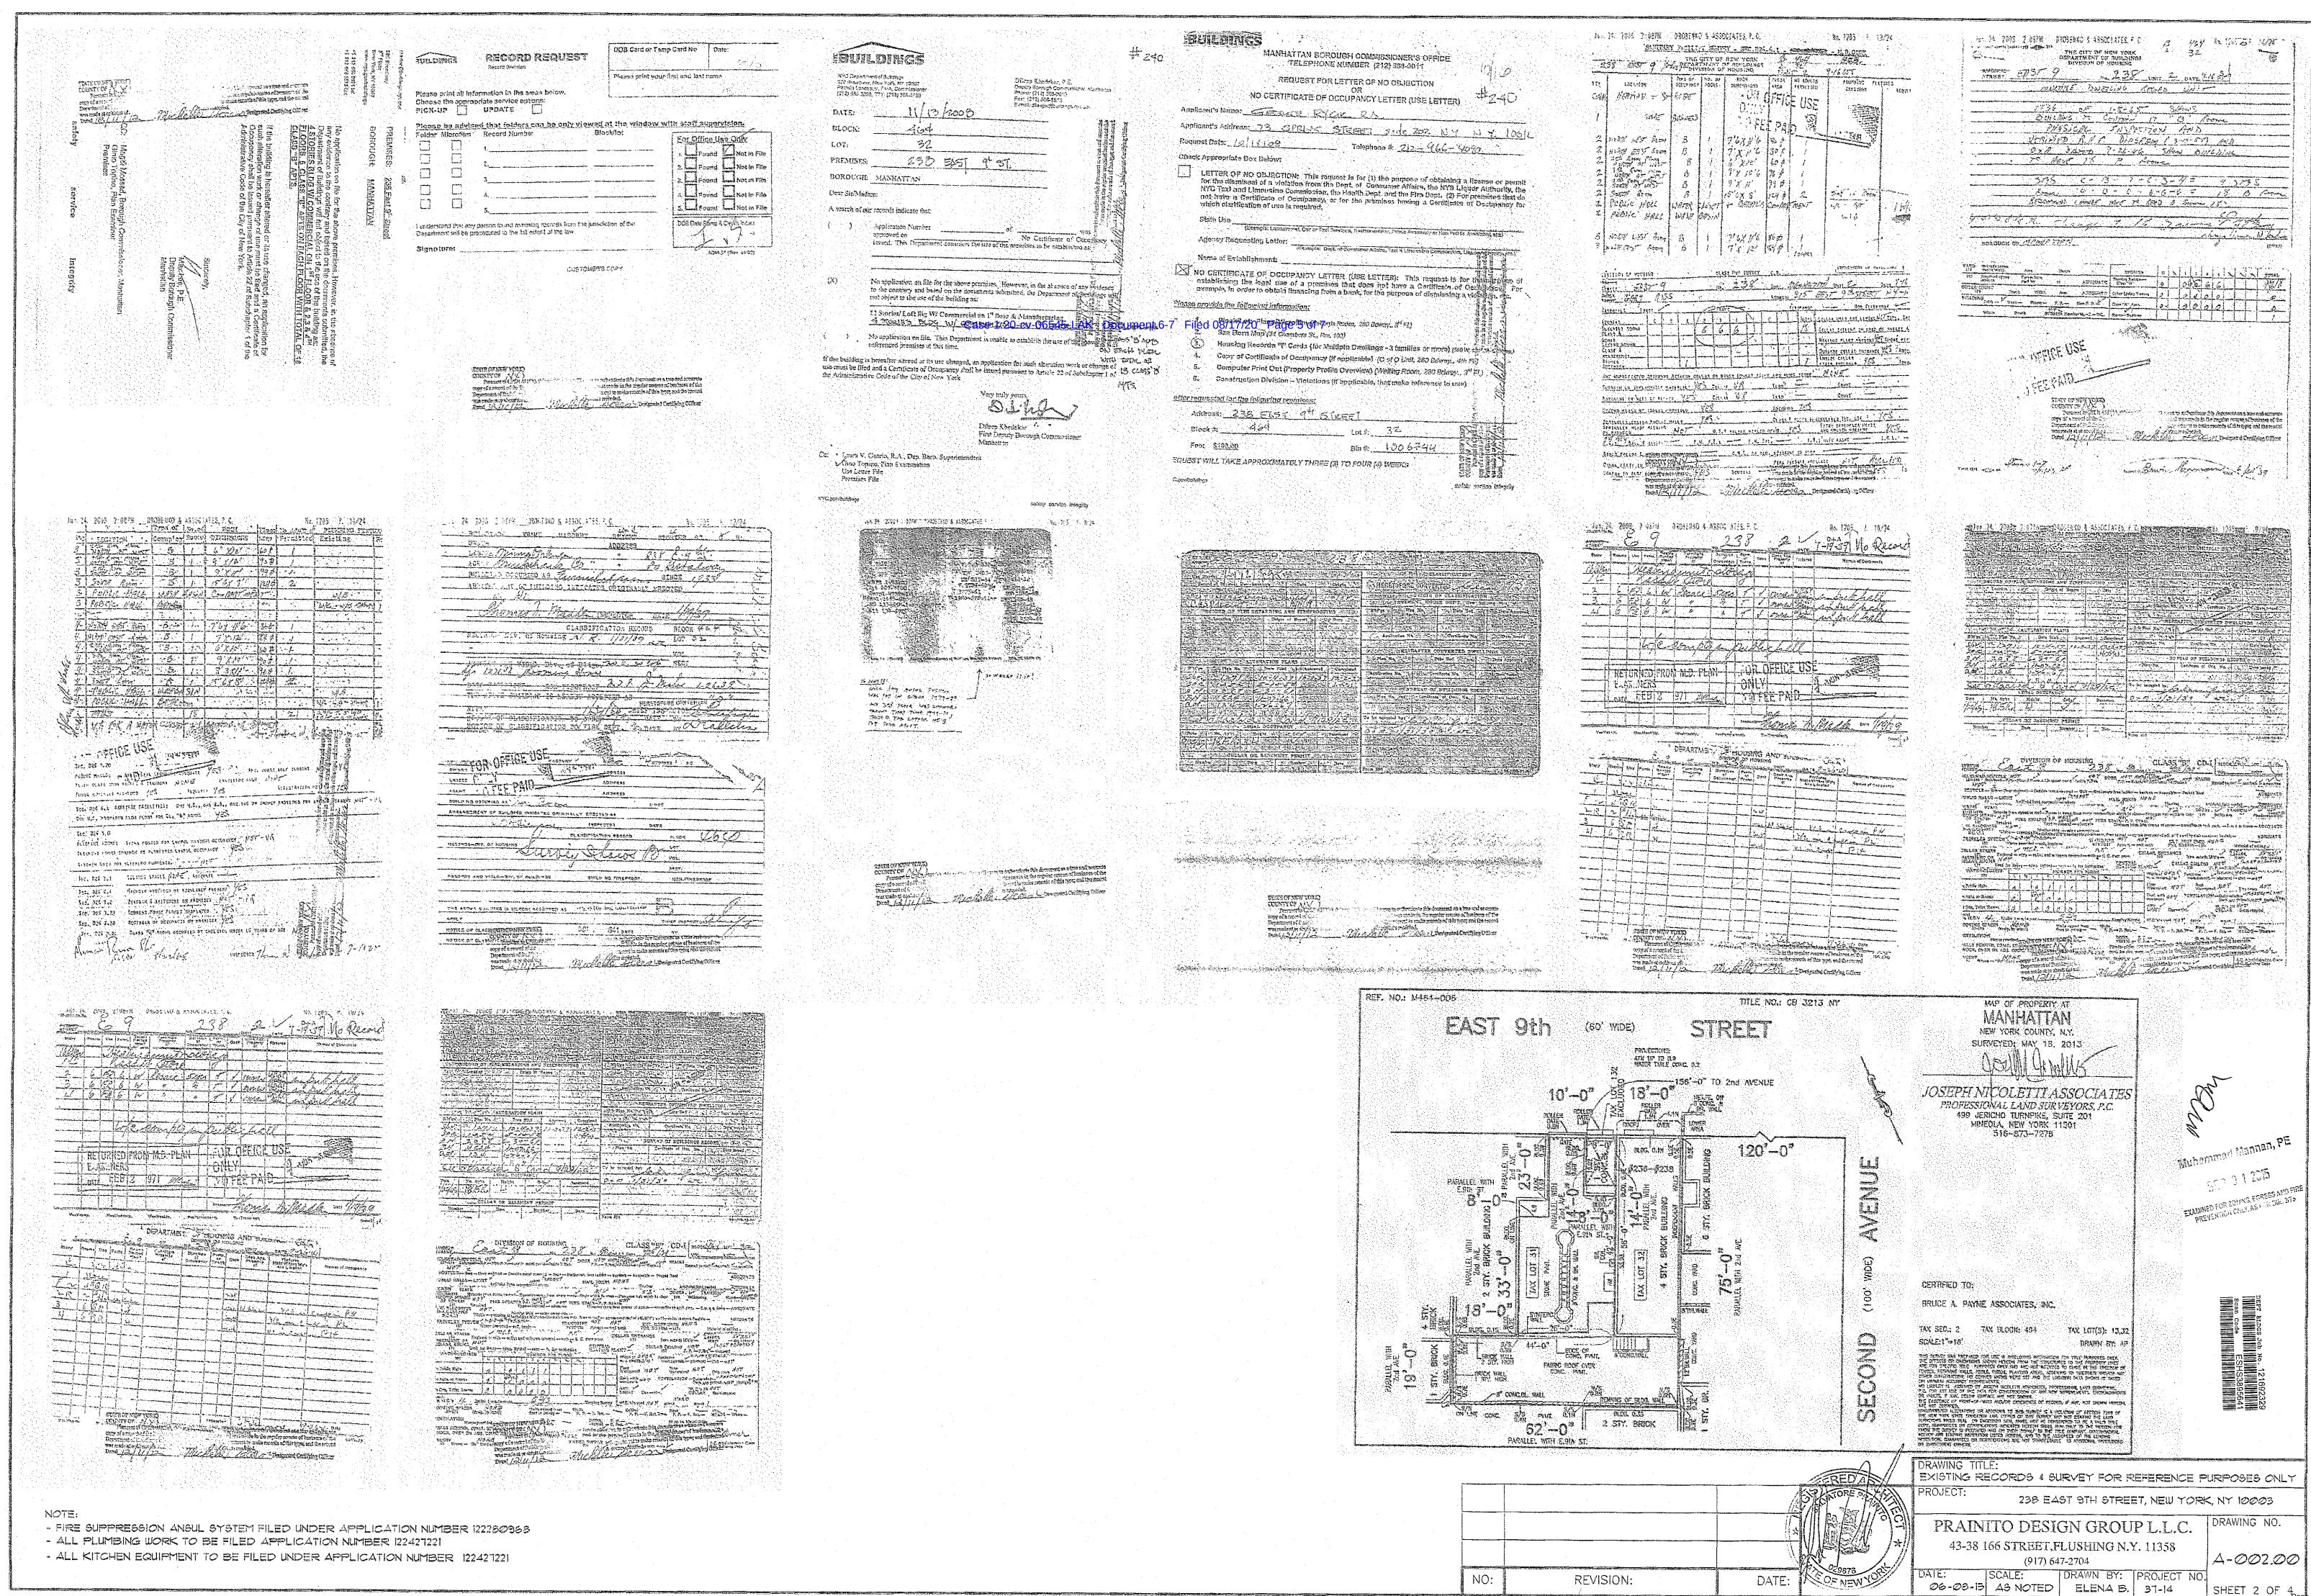

Page 6 of 7

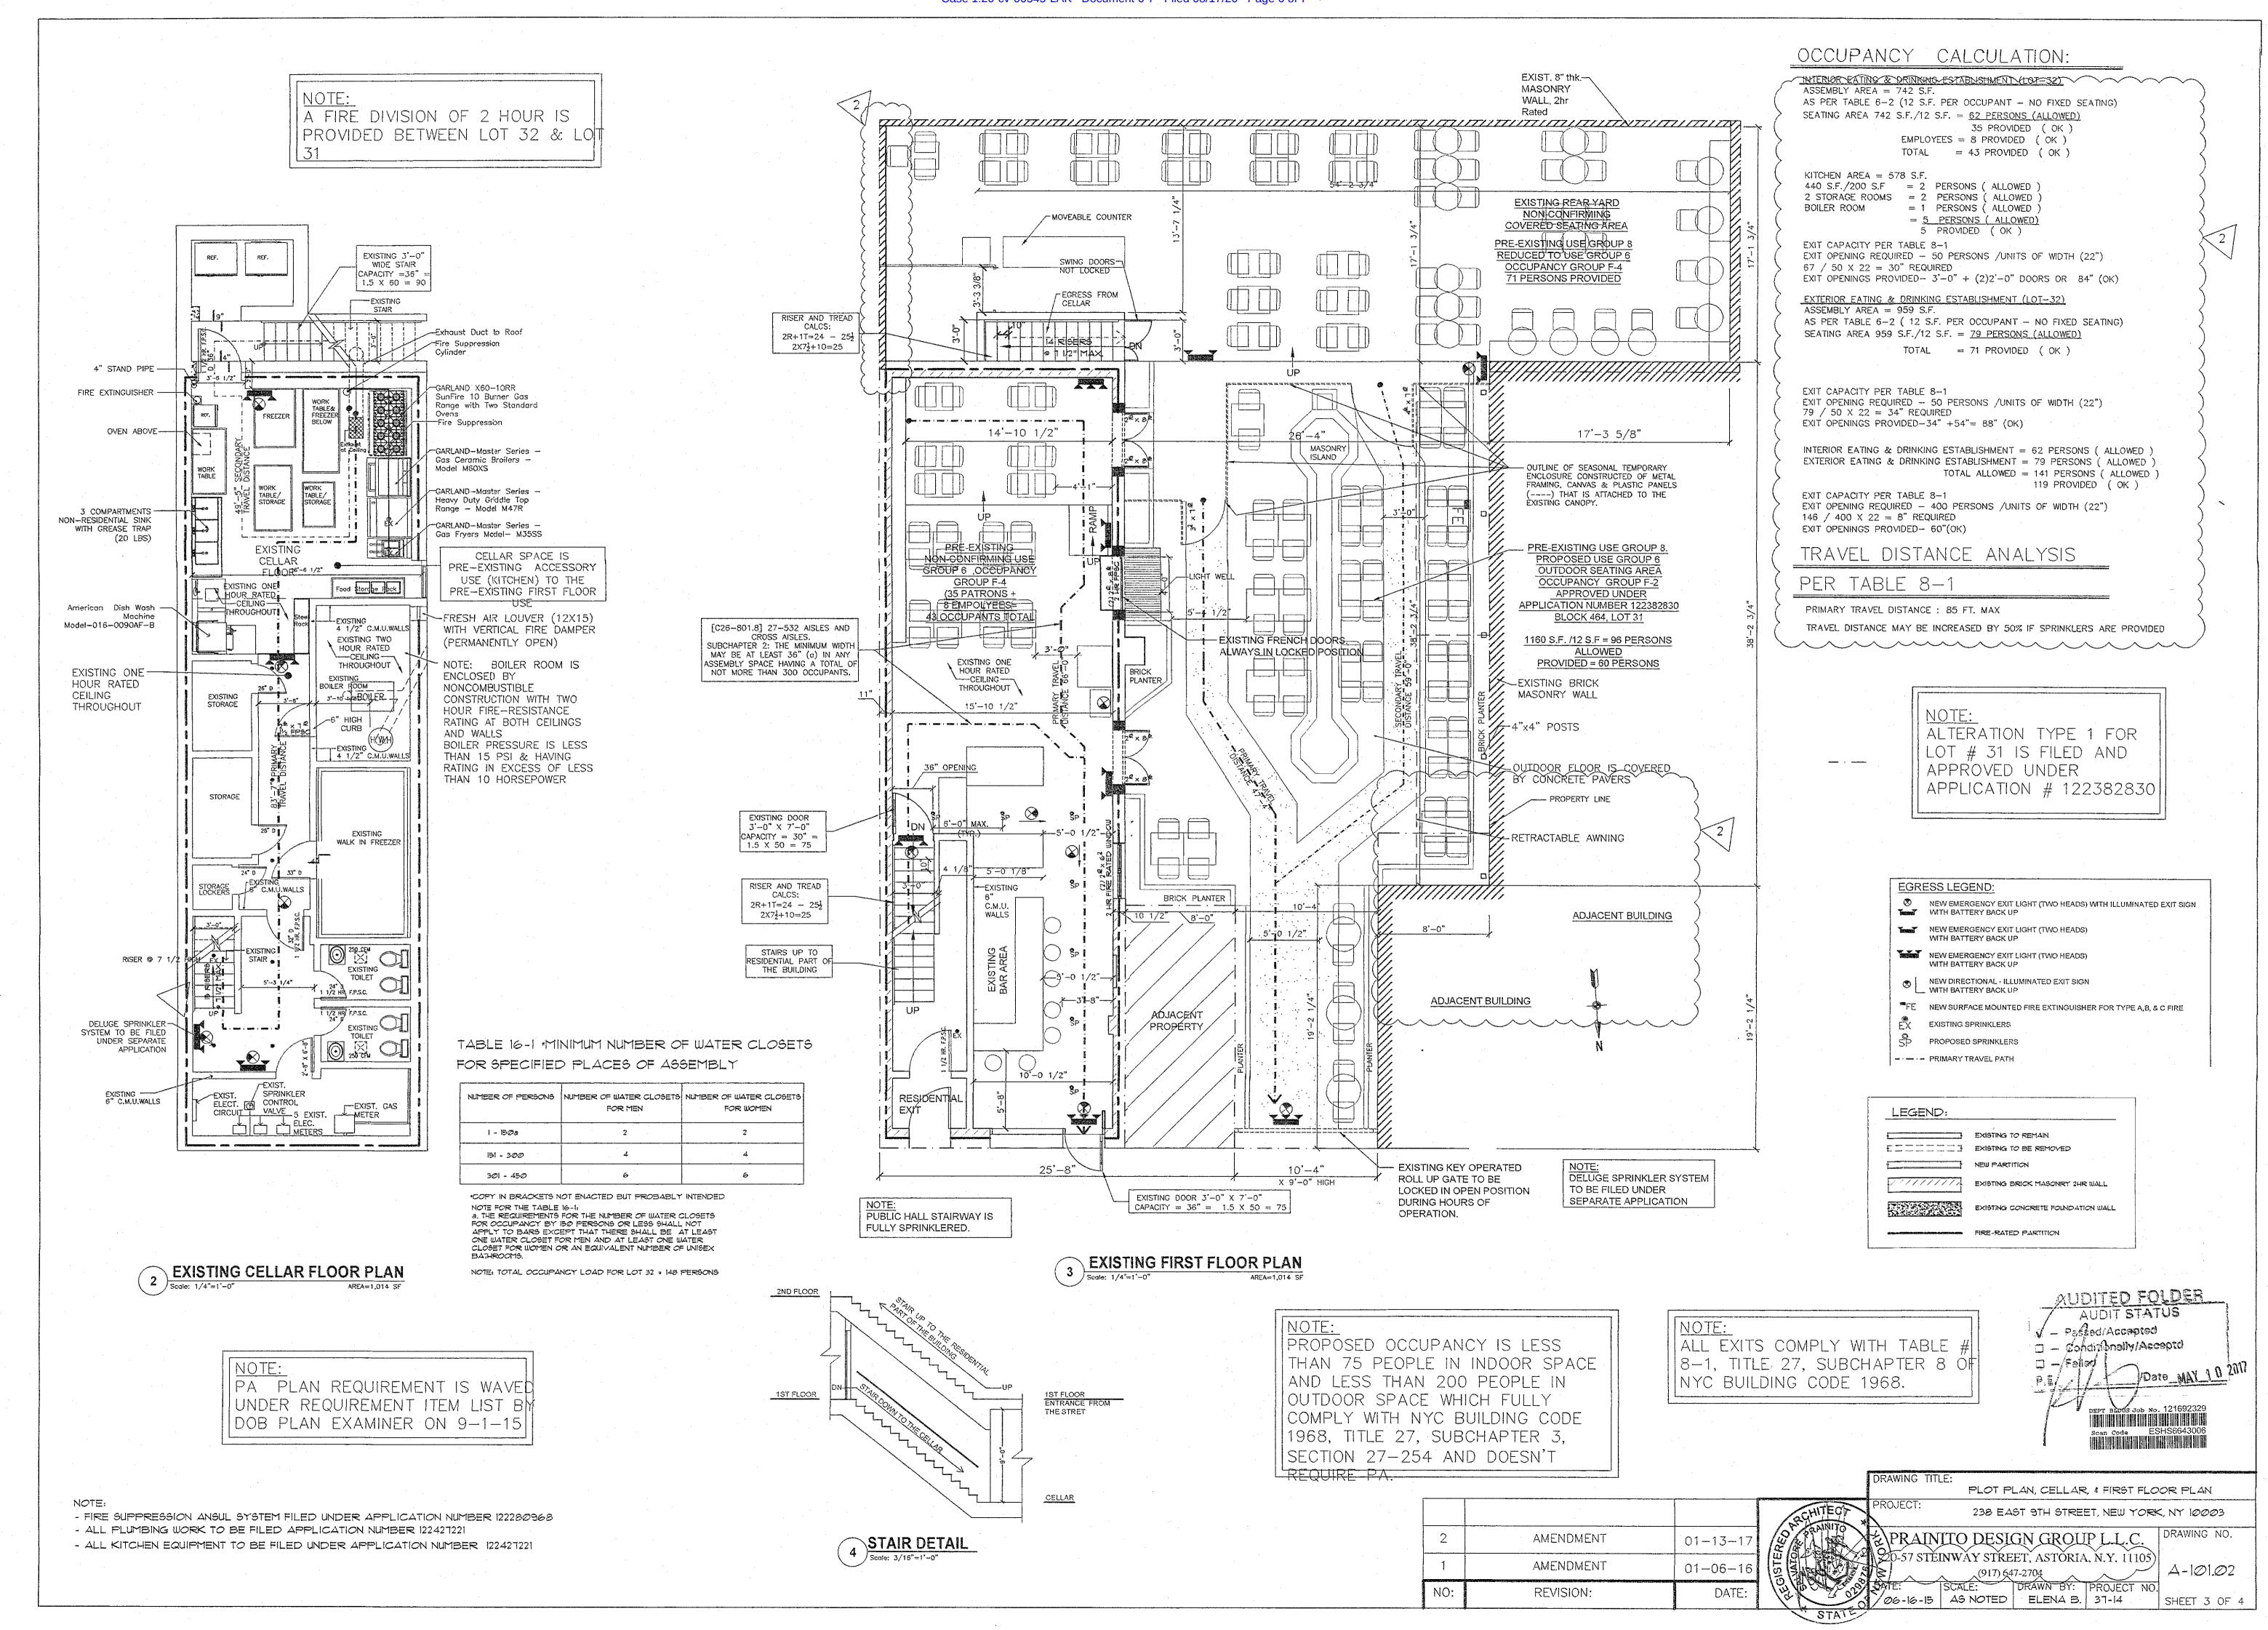

Page 7 of 7

SHEET 4 OF 4